


PACIFIC HIGHWAY

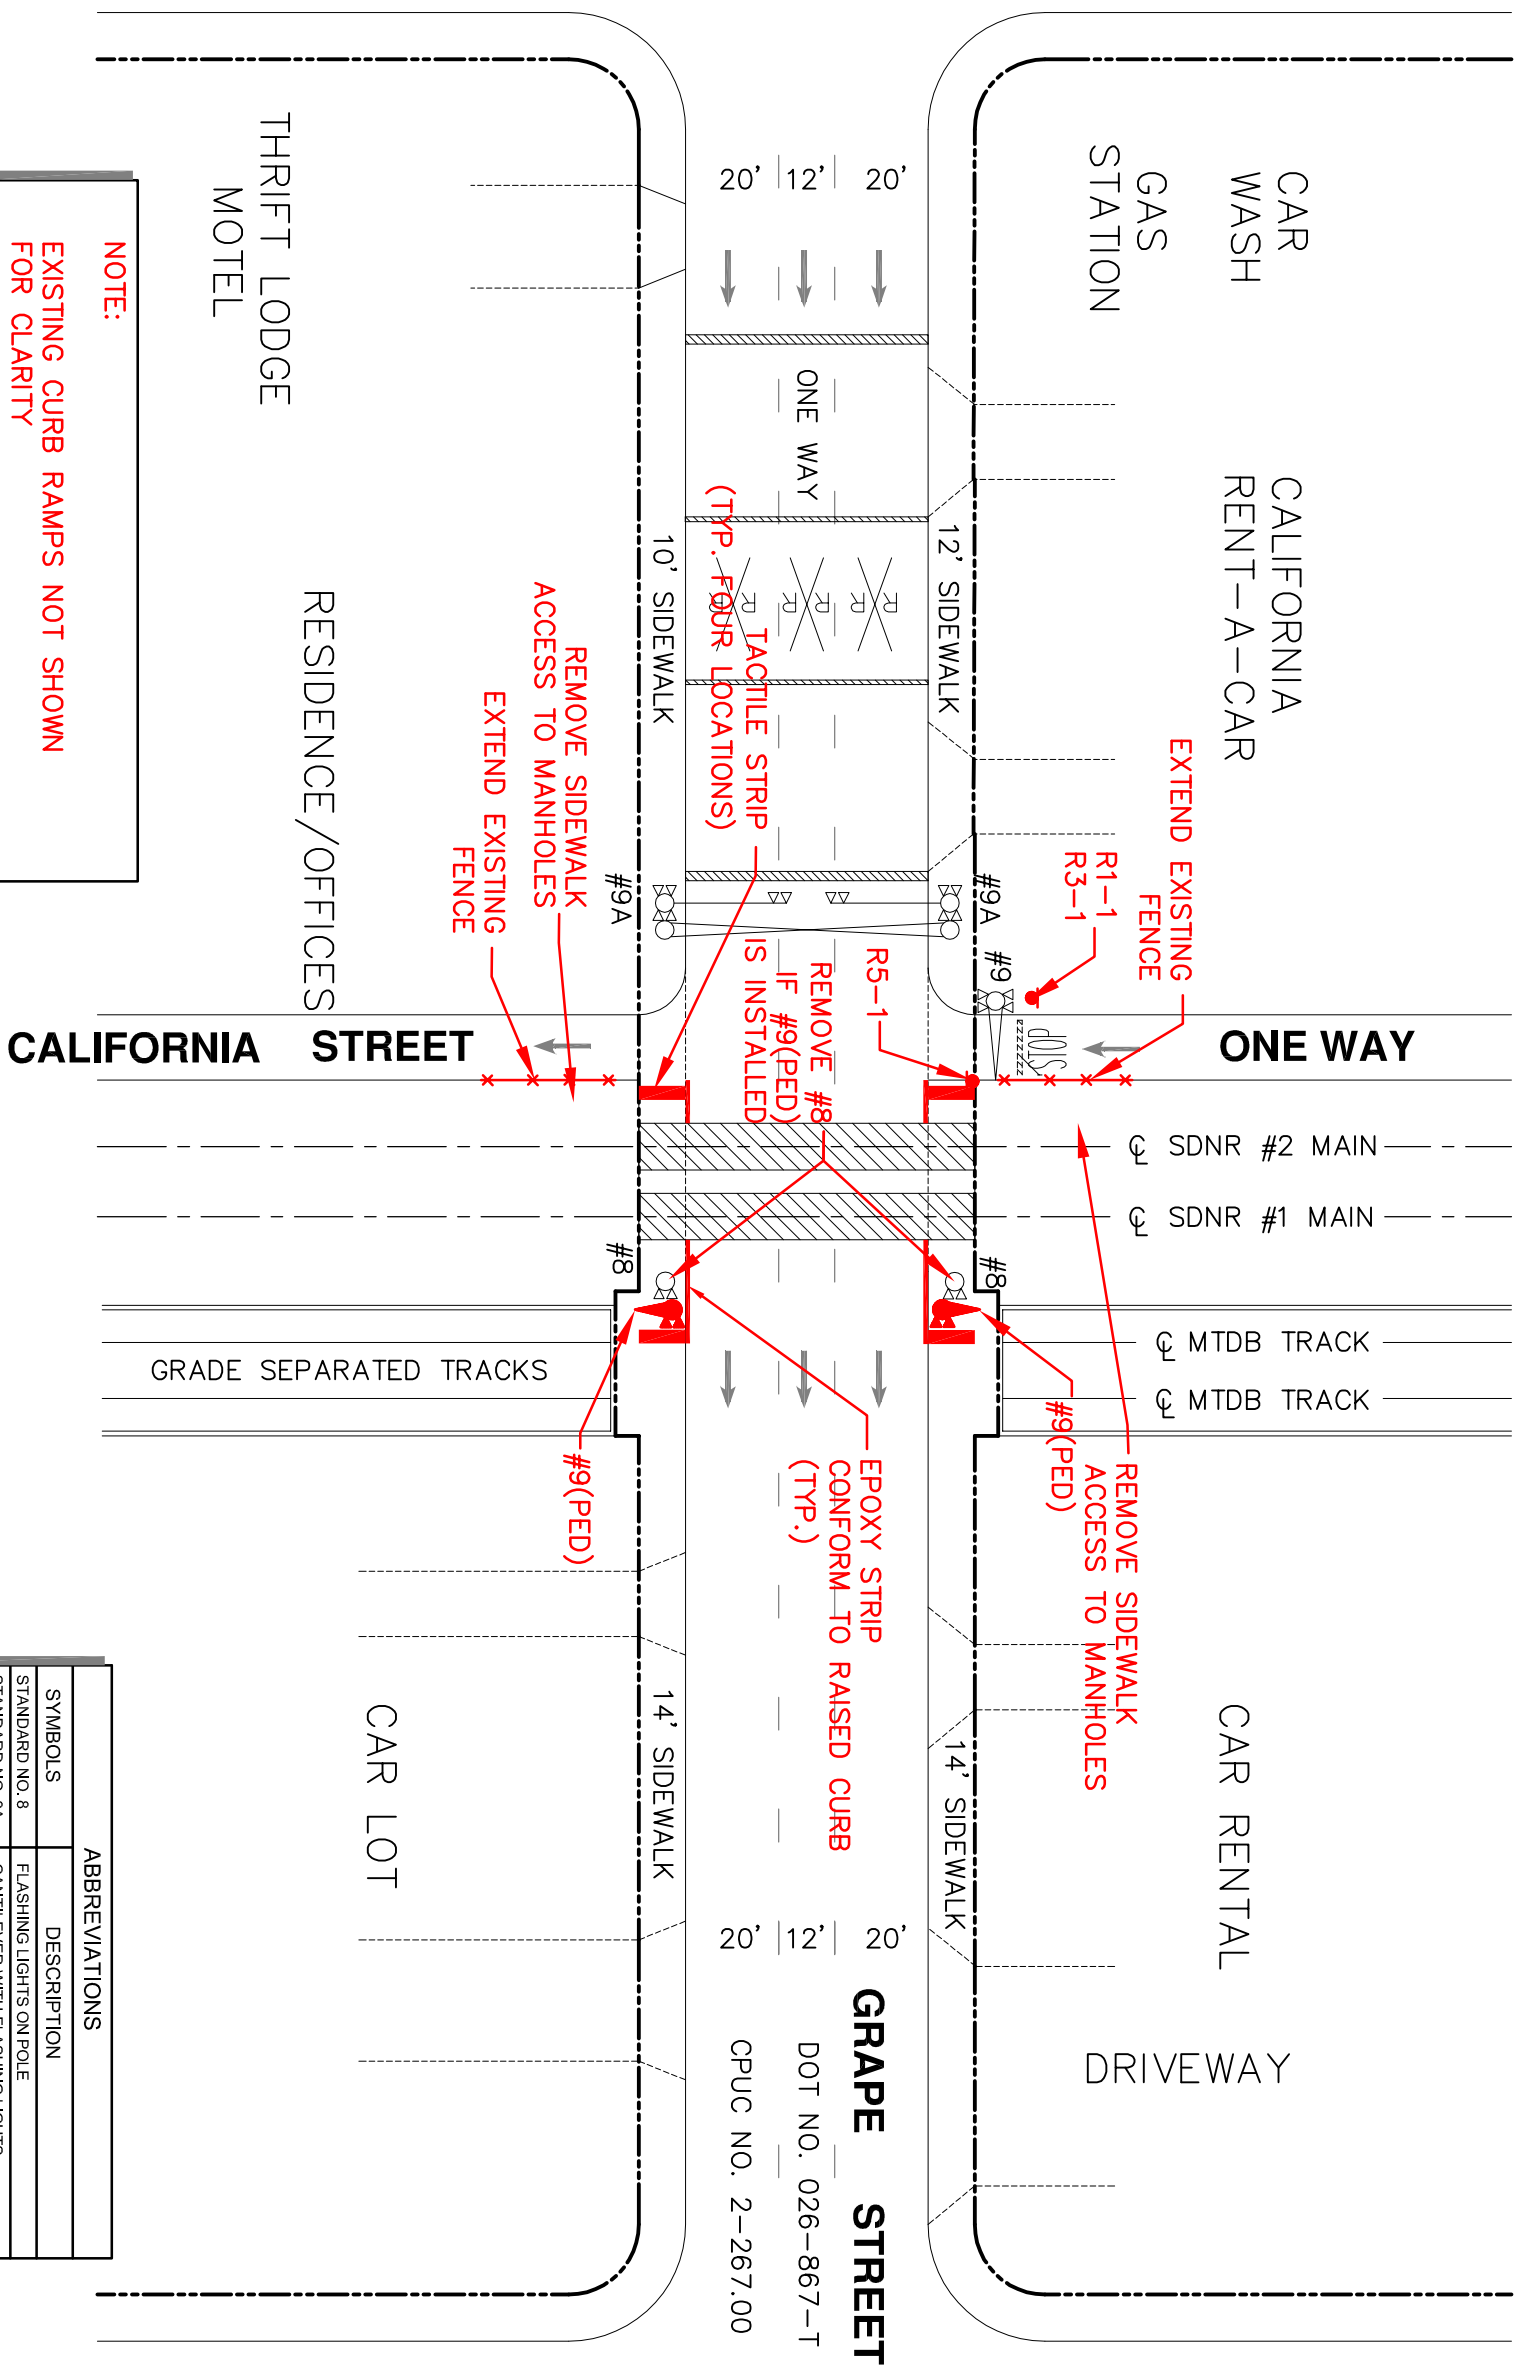

NOTE:
EXISTING CURB RAMPS NOT SHOWN FOR CLARITY

ABBREVIATIONS	
SYMBOLS	DESCRIPTION
STANDARD NO. 8	FLASHING LIGHTS ON POLE
STANDARD NO. 8A	CANTILEVER WITH FLASHING LIGHTS
STANDARD NO. 9	GATE WITH FLASHING LIGHTS
STANDARD NO. 9A	GATE WITH FLASHING LIGHTS AND CANTILEVER
STANDARD NO. 10	FLASHING LIGHT ON POLE
SIGN W47	RAILROAD CROSSING SIGN R X R

NOT FOR CONSTRUCTION
ALL DIMENSIONS ARE IN FEET (ft) UNLESS OTHERWISE NOTED

REV	DATE	DESCRIPTION
6	11/22/05	CHANGES PER FIELD REVIEW 11/11/05 & TAAC MEETING 11/14/05
5	11/3/05	MISCELLANEOUS REVISIONS
4	7/22/05	INCORPORATE QZTT REVIEW COMMENTS
3	6/23/05	INCORPORATE QZTT REVIEW COMMENTS
2	5/26/05	INCORPORATE QZTT REVIEW COMMENTS
1	3/4/05	INCORPORATE QZTT REVIEW COMMENTS

DESIGNED BY	DATE
JB	10/21/05

DRAWN BY	CHECKED BY	IN CHARGE
MB	JB	JB

DOWNTOWN SAN DIEGO QUIET ZONE STUDY

Centre City Development Corporation

Korve Engineering
300 B Street, Suite 100
San Diego, CA 92101
(619) 582-4982 Fax (619) 585-7488

BDS Engineering, Inc.
6539 Federal Boulevard
San Diego, CA 92121
(619) 582-4982 Fax (619) 585-7488

GRAPE STREET CONCEPTUAL PLAN

CONTRACT NO. 40413X1
DRAWING NO. GC-003
SCALE
SHEET NO. 3 OF 14

