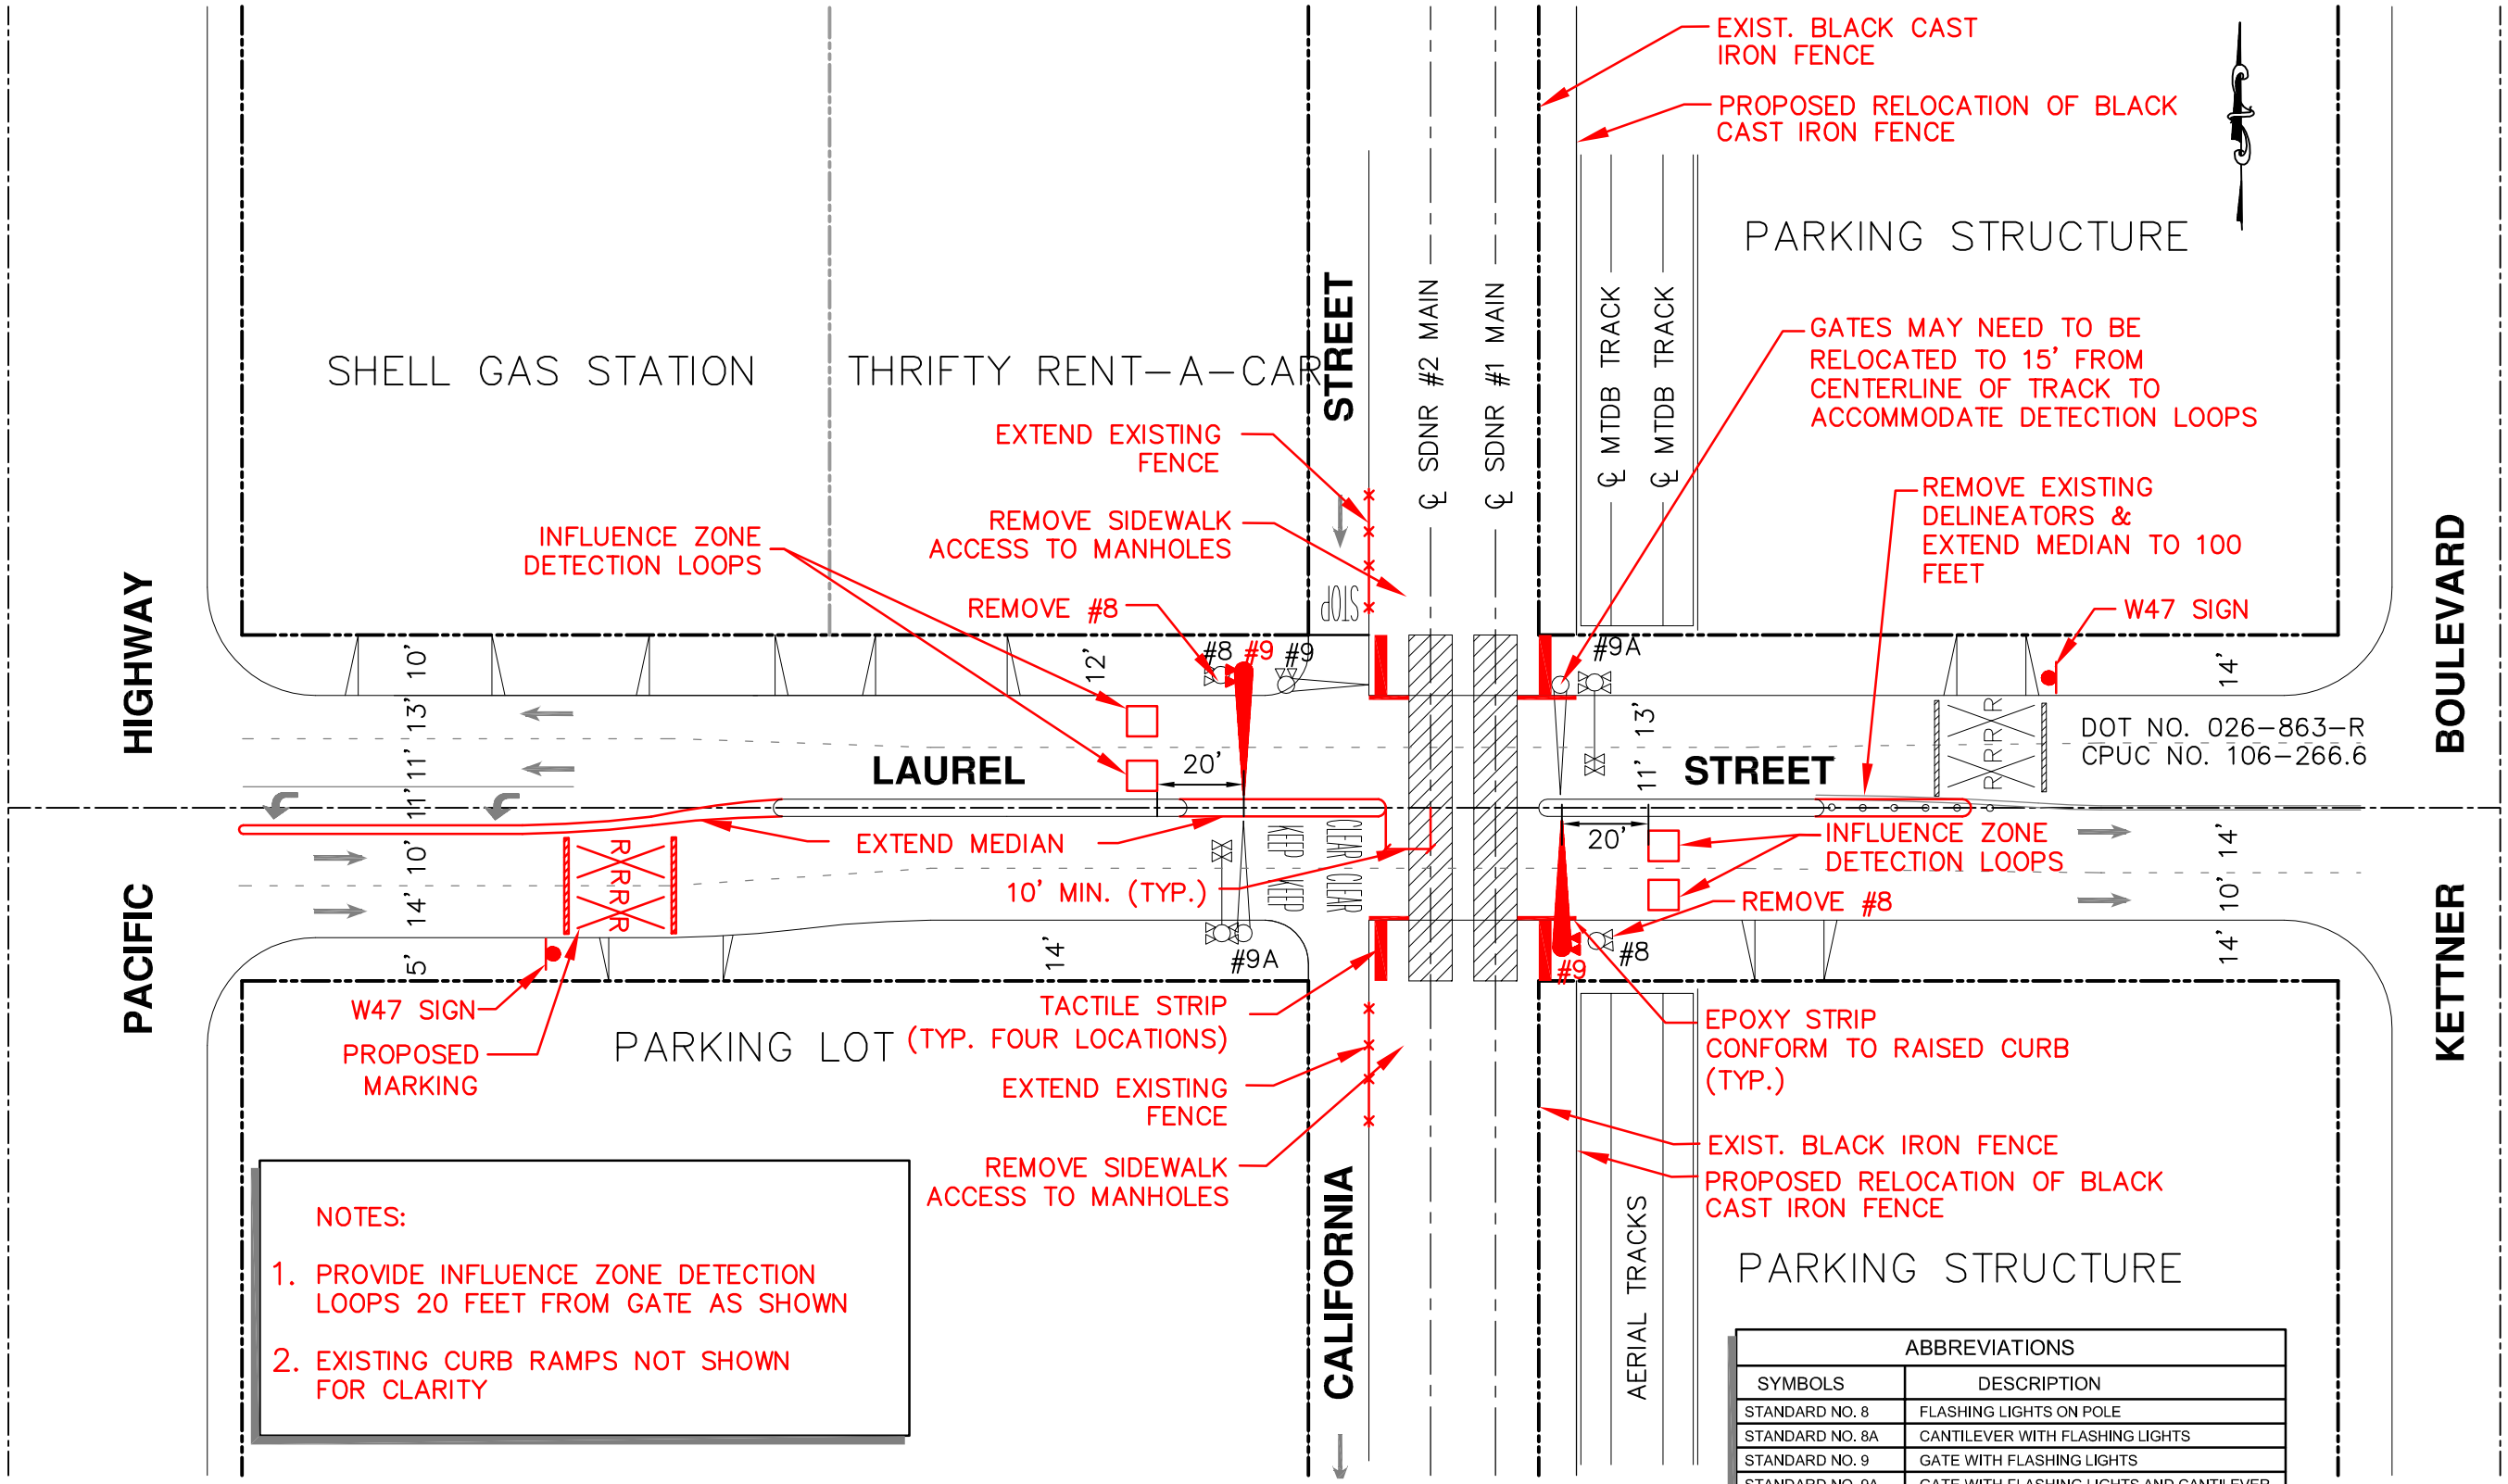

NOTES:

1. PROVIDE INFLUENCE ZONE DETECTION LOOPS 20 FEET FROM GATE AS SHOWN
2. EXISTING CURB RAMPS NOT SHOWN FOR CLARITY

ABBREVIATIONS	
SYMBOLS	DESCRIPTION
STANDARD NO. 8	FLASHING LIGHTS ON POLE
STANDARD NO. 8A	CANTILEVER WITH FLASHING LIGHTS
STANDARD NO. 9	GATE WITH FLASHING LIGHTS
STANDARD NO. 9A	GATE WITH FLASHING LIGHTS AND CANTILEVER
STANDARD NO. 10	FLASHING LIGHT ON POLE
SIGN W47	RAILROAD CROSSING SIGN R X R

NOT FOR CONSTRUCTION

ALL DIMENSIONS ARE IN FEET (ft) UNLESS OTHERWISE NOTED

REV	DATE	DESCRIPTION
6	11/22/05	CHANGES PER FIELD REVIEW 11/11/05 & TAAC MEETING 11/14/05
5	11/3/05	MISCELLANEOUS REVISIONS
4	7/22/05	INCORPORATE QZTT REVIEW COMMENTS
3	6/23/05	INCORPORATE QZTT REVIEW COMMENTS
2	5/26/05	INCORPORATE QZTT REVIEW COMMENTS
1	3/4/05	INCORPORATE QZTT REVIEW COMMENTS

DESIGNED BY JB
DRAWN BY MB
CHECKED BY JB
IN CHARGE JB
DATE 10/21/05

DOWNTOWN SAN DIEGO QUIET ZONE STUDY

Centre City Development Corporation

Korve Engineering, 525 B STREET, SUITE 1500, SAN DIEGO, CA 92101

BDS Engineering, Inc. Civil Engineering Land Surveying, 6859 Federal Boulevard, Lemon Grove, California 91945, (619) 582-4992 FAX (619) 582-7428

LAUREL STREET CONCEPTUAL PLAN

CONTRACT NO. 404113X1

DRAWING NO. GC-001 REV 6

SCALE

SHEET NO. 1 OF 14